

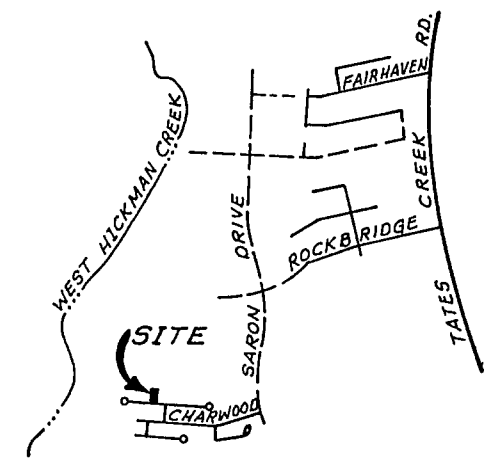
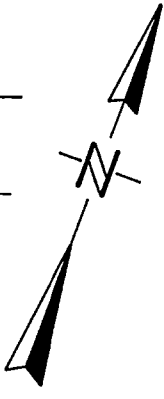


27th DAY OF APR 1987

DONALD W. BLEVINS
FAYETTE COUNTY CLERK
BY *[Signature]* D.C.

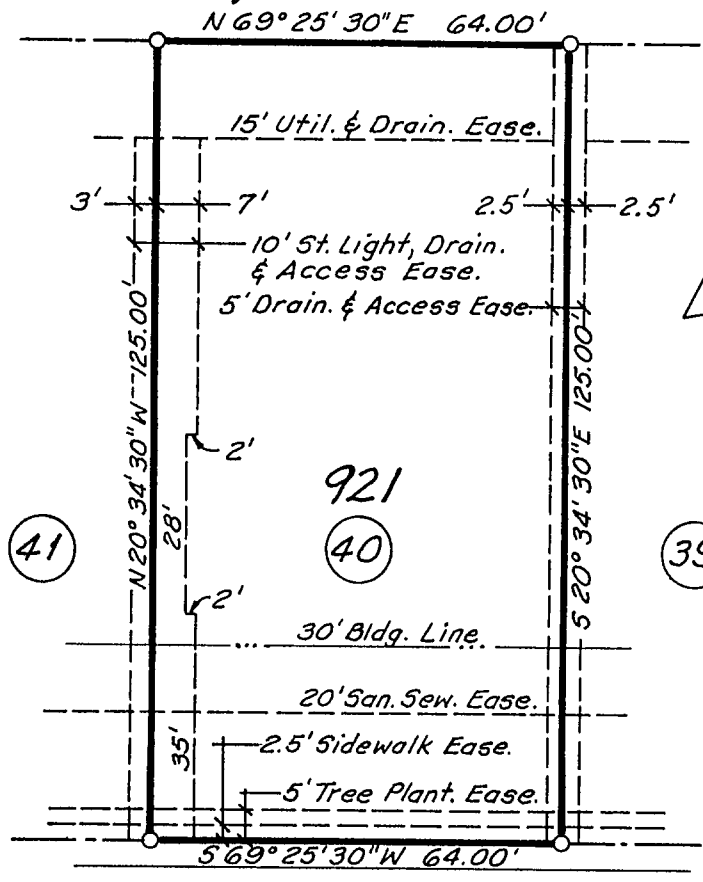

VICINITY MAP
NOT TO SCALE

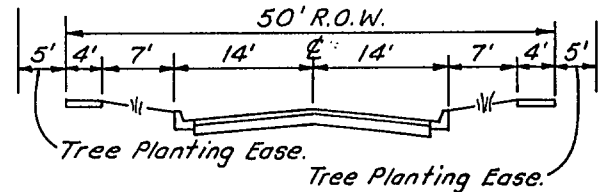

SECTION - WOODGLEN COURT
NOT TO SCALE

NOTES:

1. THE PURPOSE OF THIS AMENDED FINAL RECORD PLAT IS TO REVISE THE 10 FOOT STREET LIGHT, DRAINAGE AND ACCESS EASEMENT BETWEEN LOT 40 AND 41, BLOCK "B".
2. THIS AMENDED PLAT IS SUBJECT TO ALL NOTES, EASEMENTS AND RESTRICTIONS OF RECORD AS ARE APPLICABLE AND AS SHOWN BY FINAL RECORD PLAT OF ASHMOOR SUBDIVISION - UNIT 1-B RECORDED IN PLAT CABINET "F", SLIDE 391; AND AS SHOWN BY AMENDED MINOR SUBDIVISION EASEMENT PLAT RECORDED IN PLAT CABINET "F", SLIDE 427 IN THE FAYETTE CO. CLERK'S OFFICE.

WOODGLEN COURT

OWNER'S CERTIFICATION

I DO HEREBY CERTIFY THAT I AM THE OWNER OF RECORD OF THE PROPERTY PLATTED HEREON, WHICH IS RECORDED IN PLAT CABINET "F" SLIDE 427 IN THE FAYETTE COUNTY CLERK'S OFFICE; DO HEREBY ADOPT THIS AS MY PLAN OF LOTS FOR THIS PROPERTY; DO HEREBY DEDICATE THE STREETS AND ANY OTHER SPACES SO INDICATED TO PUBLIC USE; AND DO ESTABLISH THAT THE EASEMENTS SHOWN HEREON ARE RESERVED FOR THE USE SO INDICATED AND NO STRUCTURE, TREE OR OTHER OBSTRUCTION OF ANY KIND SHALL BE ERRECTED OR PERMITTED TO REMAIN UPON OR OVER ANY PORTION OF SAID EASEMENTS; AND DO HEREBY DEDICATE THE SANITARY SEWER SYSTEM TO PUBLIC USE. ALSO I DO HEREBY AGREE THAT BEFORE ANY LOT HEREIN IS SOLD OR TRANSFERRED, THE PURCHASER SHALL BE NOTIFIED IN THE CONTRACT OR DEED OF ANY PRIVATE UTILITIES (WATER, GAS, ELECTRICITY, TELEPHONE, AND WHERE APPLICABLE, SANITARY SEWERS) NOT INSTALLED, AND THE CONTRACT OR DEED SHALL CONTAIN A STATEMENT THAT NO BUILDING OCCUPANCY CERTIFICATE MAY BE SECURED UNTIL ANY SUCH UTILITY IS INSTALLED.

Mark Stanley 4/21/87
OWNER DATE
2353 THE WOODS LANE
ADDRESS
Patricia B. Wilson 4/21/87
WITNESS DATE
1081 Dove Run Road
ADDRESS

ENGINEER'S & SURVEYOR'S CERTIFICATION

I DO HEREBY CERTIFY THAT THIS RECORD PLAT WAS PREPARED BY ME OR UNDER MY DIRECTION; THAT ALL WORK PERFORMED BY ME OR UNDER MY DIRECTION, INCLUDING ENGINEERING DESIGN, WAS DONE IN ACCORDANCE WITH THE PROVISIONS OF THE LAND SUBDIVISION REGULATIONS AND THE REQUIREMENTS OF THE PLANNING COMMISSION; THAT ALL MONUMENTS INDICATED HEREON DO EXIST AND THEIR LOCATIONS, SIZE AND MATERIALS ARE CORRECTLY SHOWN; THAT TO THE BEST OF KNOWLEDGE AND BELIEF, THE INFORMATION SHOWN HEREON IS ACCURATE.

Tim Thompson 4.17.87
ENGINEER & SURVEYOR DATE

URBAN-CO. ENGINEER'S CERTIFICATION

I DO HEREBY CERTIFY THAT ALL PUBLIC IMPROVEMENTS HAVE BEEN INSPECTED AND FOUND TO BE INSTALLED AND "AS-BUILT" CONSTRUCTION DRAWINGS RECEIVED AND ALL ARE IN CONFORMANCE WITH THE REQUIREMENTS OF THE PLANNING COMMISSION AND ITS SUBDIVISION REGULATIONS.



David [Signature] 4/27/87
URBAN-CO. ENGINEER DATE

COMMISSION'S CERTIFICATION

I DO HEREBY CERTIFY THAT THIS RECORD PLAT WAS APPROVED BY THE URBAN COUNTY PLANNING COMMISSION AT ITS MEETING ON MARCH 19, 1987 AND IS NOW ELIGIBLE FOR RECORDING.

Christopher D. [Signature] 4/27/87
SECRETARY DATE

GRAPHIC SCALE

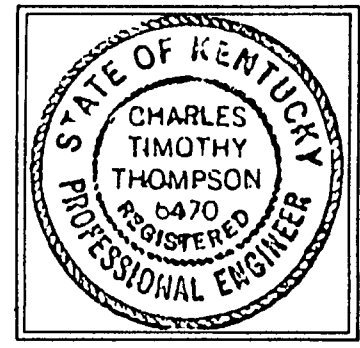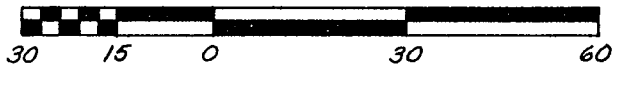

AMENDED FINAL RECORD PLAT OF
LOT 40, BLOCK "B"
ASHMOOR SUBDIVISION
UNIT 1-b
IN LEXINGTON, FAYETTE CO., KY.
SCALE: 1" = 30' FEBRUARY, 1987